


ACKLEY

St.
Pl.
Ave. No. 1-3

Name of Owner

Labor and Mat'l. Report

19

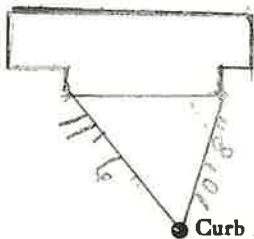

6" Main

Elev. of
Main at tap 4'

Gate at ●

● Gate at

● Curb Box

LABOR AND MATERIALS

| | | | | | |
|----|--------------------------|--|-------|---------|-------|
| 1 | Copper Lead | Connection | 3/4 | \$ | |
| 1 | Curb | Cock Valve T.S. & V. | | in. | \$ |
| 1 | Service box Old returned | Short 3 1/2 x 4 1/2 Long 4 1/2 x 5 1/2 Buff or Rdway | | \$ | |
| 22 | Ft. 3/4 in. | Copper S.T. C.T. | | Pipe at | \$ |
| | Nipples | in. | at | \$ | |
| | Bushings | to | in. | at | \$ |
| | Red'g Inc'g | Coupl'gs | to | in. | at \$ |
| | Union | in. | at | \$ | |
| | Meter | in. | at | \$ | |
| | Lead Joints | at | \$ | | |
| | Compound Joints | at | \$ | | |
| | Maintenance Foreman | | \$ | | |
| | Hrs. Water Maint. Man-1 | at | \$ | | |
| | Hrs. Water Maint. Man-2 | at | \$ | | |
| | Hrs. Garage Foreman | at | \$ | | |
| | Hrs. Labor | at | \$ | | |
| | Hrs. Compressor | at | \$ | | |
| | Compensation Ins. | at \$ | per C | \$ | |
| | Trucking | | \$ | | |
| | Pav't Patch | | \$ | | |
| | | | \$ | | |
| | | | \$ | | |
| | | | \$ | | |
| | O'head | | \$ | | |
| | | | \$ | | |