

### Labor and Materials

Copper	Connection	3	\$ 1.46
Curb	Cock Valve	3	\$ 1.93
Service Box	Short 3 1/2 x 4 1/2	}	\$ 1.77
Old returned	Long 4 1/2 x 5 1/2		
	Buff on Roadway		
20 Ft. 3/4 in.	Copper Galv. Iron Cast Iron	Pipe at 22	\$ 4.40
Nipples	in. at		\$
Bushings	to in. at		\$
Red'g Inc'g	Conplings to in. at		\$
Union	in. at		\$
Meter	in. at		\$
Lead Joints	at		\$
Leadite Joints	at		\$
Hrs. Foreman	at		\$
3 Hrs. Chauffeur	at 62 1/2		\$ 1.88
Hrs. Tapper	at		\$
16 Hrs. Labor	at 45		\$ 7.20
Hrs. Labor	at		\$
Hrs. Compressor	at		\$
Compensation Ins.			\$ 28
Trucking			\$ 1.00
Builders Use of Water			\$ 10.00
Tap made by Power			\$
			\$
			\$ 29.92

25-1937

7 Hickley


St. Pl. Ave. No. 547

Name of Owner

Frank Miller

Labor and Mat'l. Report

May 20, 1937

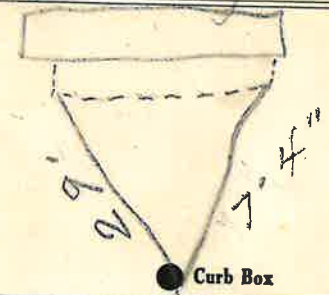

6 Main

Elev. of Main at tap 5 1/2

Gate at ●

● Gate at

● Curb Box

old dug up

No Charge