


LABOR AND MATERIALS

Copper	} Connection	_____	\$ _____
Lead			
Curb	} Cock Valve } T. S. & V. }	_____ in. _____	\$ _____
Service box		} Short 3½ x 4½ } } Long 4½ x 5½ }	
Old returned			
7'8" Ft. 3/4 in.	} Copper } } G.I. } } C.I. }	Pipe at _____	\$ _____
Nipples		_____ in. at _____	\$ _____
Bushings	_____ to _____ in. at _____	\$ _____	
Red'g } Inc'g }	} Coupl'gs _____ to _____ in. at _____	\$ _____	
Union		_____ in. at _____	\$ _____
Meter	_____ in. at _____	\$ _____	
Compound Joints	at _____	\$ _____	
Maintenance Foreman	_____	\$ _____	
Hrs. Water Maint. Man-1	at _____	\$ _____	
Hrs. Water Maint. Man-2	at _____	\$ _____	
Hrs. Garage Foreman	at _____	\$ _____	
Hrs. Labor	at _____	\$ _____	
Hrs. Compressor	at _____	\$ _____	
Trucking	_____	\$ _____	
Pav't Patch	_____	\$ _____	
		\$ _____	
		\$ _____	
St. Arlington
Pt. Ave. No. 21

Name of Owner _____

Labor and Mat'l. Report 1971

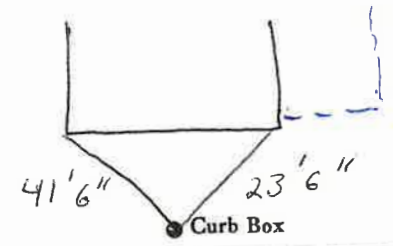

Main _____ Elev. of Main at tap _____
Gate at • _____ Gate at _____

• Curb Box

(Note: Do not paint in Drive Way)

