

LABOR AND MATERIALS


Copper	} Connection	_____	\$ _____	
Lead				
Curb	} Cock } Valve } T. S. & V. }	_____ in.	\$ _____	
Service box Old returned		} Short 3½ x 4½ } Long 4½ x 5½ }		
				\$ _____
Ft. <u>3/4</u> in.	} Copper } G. I. } G. I.	Pipe at _____	\$ _____	
Nipples _____ in. at _____			\$ _____	
Bushings _____ to _____ in. at _____		\$ _____		
Red'g } Inc'g }	} Coupl'gs _____ to _____ in. at _____		\$ _____	
Union _____ in. at _____			\$ _____	
Meter _____ in. at _____		\$ _____		
Compound Joints at _____		\$ _____		
Maintenance Foreman _____		\$ _____		
Hrs. Water Maint. Man—1 at _____		\$ _____		
Hrs. Water Maint. Man—2 at _____		\$ _____		
Hrs. Garage Foreman _____ at _____		\$ _____		
Hrs. Labor— _____ at _____		\$ _____		
Hrs. Compressor at _____		\$ _____		
Trucking _____		\$ _____		
Pav't Patch _____		\$ _____		
		\$ _____		
		\$ _____		
		\$ _____		
		\$ _____		

ARLINGTON

St. ~~Pl.~~
Ave. No. 23

Name of Owner _____

Labor and Mat'l. Report _____ 1992

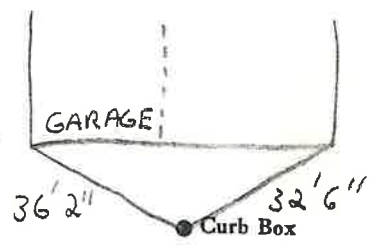

Main _____ Elev. of Main at tap _____
Gate at ● _____ ● Gate at _____

● Curb Box