

LABOR AND MATERIALS


Copper	} Connection		\$	
Lead				
Curb	} Cock } Valve } T. S. & V.	in.	\$	
Service box		} Short 3½ x 4½ } Long 4½ x 5½		
Old returned				\$
47 Ft.	} Copper } C.I. } C.I.	3/4 in.	Pipe at \$	
Nipples	in. at		\$	
Bushings	to in. at		\$	
Red'g	} Coupl'gs	to in. at	\$	
Inc'g				
Union	in. at		\$	
Meter	in. at		\$	
			\$	
Compound Joints	at		\$	
Maintenance Foreman			\$	
Hrs. Water Maint. Man	1 at		\$	
Hrs. Water Maint. Man	2 at		\$	
Hrs. Garage Foreman	at		\$	
Hrs. Labor	at		\$	
Hrs. Compressor	at		\$	
			\$	
Trucking			\$	
Pav't Patch			\$	
			\$	
			\$	
			\$	
			\$	

24 Arlington St. Ave. No. 24

Name of Owner

Labor and Mat'l. Report

1988

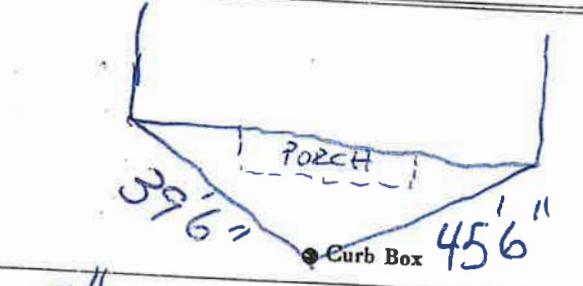

8"

Main

Elev. of Main at tap

Gate at ●

● Gate at

● Curb Box