


LABOR AND MATERIALS

| | | | |
|-------------------------|---|----------------|-----------------------|
| 3/4" Copper Lead | Connection | _____ | \$ _____ |
| Curb | Cock Valve } T. S. & V. } | _____ in. | \$ _____ |
| | | _____ in. | \$ _____ |
| | | _____ in. | \$ _____ |
| Service box | Short 3 1/2 x 4 1/2 } Long 4 1/2 x 5 1/2 } | _____ | \$ _____ |
| Old returned | | _____ | \$ _____ |
| 48' Ft. 3/4" in. | Copper } C.T. } C.T. } | Pipe at _____ | \$ _____ |
| Nipples | _____ in. | at _____ | \$ _____ |
| Bushings | _____ to _____ | in. at _____ | \$ _____ |
| Red'g } Inc'g } | Coupl'gs | _____ to _____ | in. at _____ \$ _____ |
| Union | | _____ in. | at _____ \$ _____ |
| Meter | _____ in. | at _____ | \$ _____ |
| Compound Joints | at _____ | | \$ _____ |
| Maintenance Foreman | | | \$ _____ |
| Hrs. Water Maint. Man-1 | at _____ | | \$ _____ |
| Hrs. Water Maint. Man-2 | at _____ | | \$ _____ |
| Hrs. Garage Foreman | at _____ | | \$ _____ |
| Hrs. Labor | at _____ | | \$ _____ |
| Hrs. Compressor | at _____ | | \$ _____ |
| Trucking | | | \$ _____ |
| Pav't Patch | | | \$ _____ |
| | | | \$ _____ |
| | | | \$ _____ |
| | | | \$ _____ |
| | | | \$ _____ |

(A)
ARLINGTON St. 26
 Ave. No. 26

Name of Owner _____

Labor and Mat'l. Report _____ 19

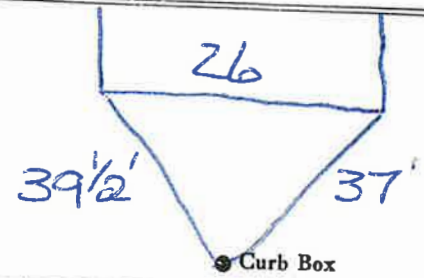

8" Main Elev. of Main at tap _____
 Gate at ● Gate at ●

● Curb Box