

LABOR AND MATERIALS

3/14" }  
 Copper } Connection \_\_\_\_\_ \$  
 Lead }  
 Curb } Cock } \_\_\_\_\_ in. \$  
 } Valve }  
 } T. S. & V. }  
 Service box } Short 3 1/2 x 4 1/2 }  
 Old returned } Long 4 1/2 x 5 1/2 } \_\_\_\_\_ \$  
 Ft. \_\_\_\_\_ in. } Copper } Pipe at \_\_\_\_\_ \$  
 } G. I. }  
 } C. I. }  
 Nipples \_\_\_\_\_ in. at \_\_\_\_\_ \$  
 Bushings \_\_\_\_\_ to \_\_\_\_\_ in. at \_\_\_\_\_ \$  
 Red'g }  
 Inc'g } Coupl'gs \_\_\_\_\_ to \_\_\_\_\_ in. at \_\_\_\_\_ \$  
 Union \_\_\_\_\_ in. at \_\_\_\_\_ \$  
 Meter \_\_\_\_\_ in. at \_\_\_\_\_ \$  
 \_\_\_\_\_ \$  
 Compound Joints at \_\_\_\_\_ \$  
 Maintenance Foreman \_\_\_\_\_ \$  
 Hrs. Water Maint. Man-1 at \_\_\_\_\_ \$  
 Hrs. Water Maint. Man-2 at \_\_\_\_\_ \$  
 Hrs. Garage Foreman \_\_\_\_\_ at \_\_\_\_\_ \$  
 Hrs. Labor \_\_\_\_\_ at \_\_\_\_\_ \$  
 Hrs. Compressor at \_\_\_\_\_ \$  
 \_\_\_\_\_ \$  
 Trucking \_\_\_\_\_ \$  
 Pav't Patch \_\_\_\_\_ \$  
 \_\_\_\_\_ \$  
 \_\_\_\_\_ \$  
 \_\_\_\_\_ \$  
 \_\_\_\_\_ \$

Tax ID # 309.16-3-17


+13'

8 Arlington

St. \_\_\_\_\_  
 Pt. \_\_\_\_\_  
 Ass. No. 8

Name of Owner \_\_\_\_\_  
 \_\_\_\_\_

Labor and Mat'l. Report \_\_\_\_\_ 19

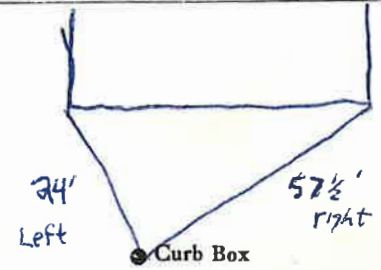

8" Main \_\_\_\_\_ Elev. of Main at tap \_\_\_\_\_  
 Gate at • \_\_\_\_\_ Gate at \_\_\_\_\_

TAX ID # 309.16-3-17

• Curb Box