


LABOR AND MATERIALS

Copper	} Connection		\$	
Lead				
Curb	} Cock	} in.	\$	
				} Valve
Service box	} Short 3½ x 4½			
Old returned		Long 4½ x 5½		\$
8 Ft. ¾ in.	} Copper	} Pipe at	\$	
				G.I.
				G.I.
Nipples	in. at		\$	
Bushings	to in. at		\$	
Red'g	} Coupl'gs	to in. at	\$	
Inc'g				
Union	in. at		\$	
Meter	in. at		\$	
			\$	
Compound Joints	at		\$	
Maintenance Foreman			\$	
Hrs. Water Maint. Man—1	at		\$	
Hrs. Water Maint. Man—2	at		\$	
Hrs. Garage Foreman	at		\$	
Hrs. Labor—	at		\$	
Hrs. Compressor	at		\$	
			\$	
Trucking			\$	
Pav't Patch			\$	
			\$	
			\$	
(etc)

St. Arlington
 Pt. Ave. No. 13
 Name of Owner Jones

Labor and Mat'l. Report 1991

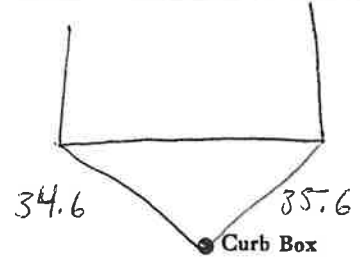

Main Elev. of Main at tap
 Gate at • Gate at

• Curb Box