

LABOR AND MATERIALS


Copper	} Connection	_____	\$ _____		
Lead					
Curb	} Cock Valve T. S. & V. }	_____ in.	\$ _____		
				Service box	} Short 3½ x 4½ }
Old returned		_____	\$ _____		
Ft. ^{3/4} in.	} Copper C.I. C.I. }	Pipe at _____	\$ _____		
Nipples _____ in. at _____				\$ _____	
Bushings _____ to _____ in. at _____				\$ _____	
Red'g } Inc'g }	} Coupl'gs _____ to _____ in. at _____	\$ _____			
Union _____ in. at _____			\$ _____		
Meter _____ in. at _____	\$ _____				
_____	\$ _____				
Compound Joints at _____	\$ _____				
Maintenance Foreman _____	\$ _____				
Hrs. Water Maint. Man—1 at _____	\$ _____				
Hrs. Water Maint. Man—2 at _____	\$ _____				
Hrs. Garage Foreman _____ at _____	\$ _____				
Hrs. Labor _____ at _____	\$ _____				
Hrs. Compressor at _____	\$ _____				
_____	\$ _____				
Trucking _____	\$ _____				
Pav't Patch _____	\$ _____				
_____	\$ _____				
_____	\$ _____				
_____	\$ _____				
_____	\$ _____				

+23'

14 Astington St. _____
 Ave. No. 14 Pt. _____

Name of Owner _____

Labor and Mat'l. Report 19 92

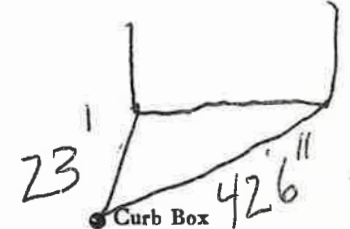

8" Main Elev. of
Main at tap _____

Gate at ● ● Gate at _____

● Curb Box