


# LABOR AND MATERIALS

_____	Copper	Connection	_____	\$	_____
_____	Lead			\$	_____
_____	Curb	Cock	_____ in.	\$	_____
_____		Valve			
_____		T.S. & V.			
_____	Service box	Short 3-1/2 x 4-1/2	_____	\$	_____
_____		Old returned Long 4-1/2 x 5-1/2			
41	Ft.	8 in.	Copper	Pipe at	\$
			C.I.		
_____	Nipples	_____ in.	at	\$	_____
_____	Bushings	_____ to _____	in.	at	\$
_____	Red'g				
_____	Inc'g				
_____	Union	_____ in.	at	\$	_____
_____	Meter	_____ in.	at	\$	_____
_____				\$	_____
_____	Compound Joints	at		\$	_____
_____	Maintenance Foreman			\$	_____
_____	Hrs. Water Maint. Man - 1	at		\$	_____
_____	Hrs. Water Maint. Man - 2	at		\$	_____
_____	Hrs. Garage Foreman	at		\$	_____
_____	Hrs. Labor	at		\$	_____
_____	Hrs. Compressor	at		\$	_____
_____				\$	_____
_____	Trucking			\$	_____
_____	Pav't Patch			\$	_____
_____				\$	_____
_____				\$	_____
A
St.  
Arlington Pl.  
Ave. No. 16

Name of Owner  
CIUTE

Labor and Mat'l. Report 19

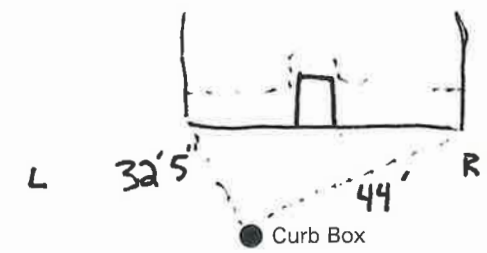

8" Main Elev. of Main at tap 5'  
 Gate at ● ● Gate at

TAX ID # 309.16-3-20

● Curb Box

LABOR AND MATERIALS

3/4 Copper } Connection _____	\$ _____
Lead } _____	
Curb } Cock _____	in. \$ _____
} Valve _____	
} T. S. & V. _____	
Service box { Short 3 1/2 x 4 1/2 }	
Old returned { Long 4 1/2 x 5 1/2 }	\$ _____
216" 3/4 in. { Copper } Pipe at _____	\$ _____
} G.I. _____	
} G.I. _____	
Nipples _____ in. at _____	\$ _____
Bushings _____ to _____ in. at _____	\$ _____
Red'g } Coupl'gs _____ to _____ in. at _____	\$ _____
Inc'g } _____	
Union _____ in. at _____	\$ _____
Meter _____ in. at _____	\$ _____
_____	\$ _____
Compound Joints at _____	\$ _____
Maintenance Foreman _____	\$ _____
Hrs. Water Maint. Man—1 at _____	\$ _____
Hrs. Water Maint. Man—2 at _____	\$ _____
Hrs. Garage Foreman _____ at _____	\$ _____
Hrs. Labor— _____ at _____	\$ _____
Hrs. Compressor at _____	\$ _____
_____	\$ _____
Trucking _____	\$ _____
Pav't Patch _____	\$ _____
_____	\$ _____
_____	\$ _____
_____	\$ _____
_____	\$ _____

(NO)


16 Arlington

St. Pl. Ave. No. 16

Name of Owner \_\_\_\_\_

Labor and Mat'l. Report

6/7 1990

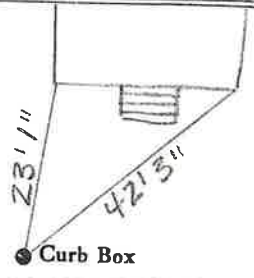

Main

Elev. of Main at tap \_\_\_\_\_

Gate at ● \_\_\_\_\_

● Gate at \_\_\_\_\_

● Curb Box