

LABOR AND MATERIALS


Copper	}	Connection	3/4"		\$
Lead					
Curb	}	Cock Valve	3/4" in.		\$
			T.S. & V.		
Service box	}	Short 3 1/2 x 4 1/2			
Old returned			Long 4 1/2 x 5 1/2		
24 Ft.	}	Copper	3/4 in.	Pipe at	\$
			C.I.		
Nipples		in. at			\$
Bushings		to in. at			\$
Red'g } Inc'g }	}	Coupl'gs	to in. at		\$
Union			in. at		
Meter		in. at			\$
Compound Joints		at			\$
Maintenance Foreman					\$
Hrs. Water Maint. Man-1		at			\$
Hrs. Water Maint. Man-2		at			\$
Hrs. Garage Foreman		at			\$
Hrs. Labor		at			\$
Hrs. Compressor		at			\$
Trucking					\$
Pav't Patch					\$
					\$
					\$
					\$
					\$

AUBURN

-St.
Pl.
Ave. No. 10

Name of Owner _____

Labor and Mat'l. Report DEC. 1927

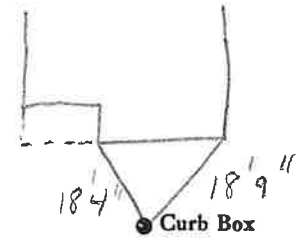

6" Main (1958) Elev. of Main at tap 5'

Gate at ● ● Gate at

● Curb Box

Old shut off