


LABOR AND MATERIALS

1	Copper	} Connection	3/4"	\$
	Lead			
1	Curb	} Cock Valve	3/4" in.	\$
1	Service box	} Short 3 1/2 x 4 1/2		\$
	Old returned			
6	Ft. 3/4 in.	} Copper	Pipe at	\$
	Nipples	in. at	\$	
	Bushings	to in. at	\$	
	Red'g	} Coupl'gs	to in. at	\$
	Inc'g			
	Union	in. at	\$	
	Meter	in. at	\$	
	Lead Joints	at	\$	
	Compound Joints	at	\$	
	Maintenance Foreman		\$	
	Hrs. Water Maint. Man-1	at	\$	
	Hrs. Water Maint. Man-2	at	\$	
	Hrs. Garage Foreman	at	\$	
	Hrs. Labor	at	\$	
	Hrs. Compressor	at	\$	
	Compensation Ins. at \$	per C	\$	
	Trucking		\$	
	Pav't Patch		\$	
	Top 6" War. s. ins. skt		\$	
	12-13-44		\$	
	O'head		\$	

St. #15
Pl. Ave. No. 11

Name of Owner
Geo. Raby

Labor and Mat'l. Report Dec. 13 1944

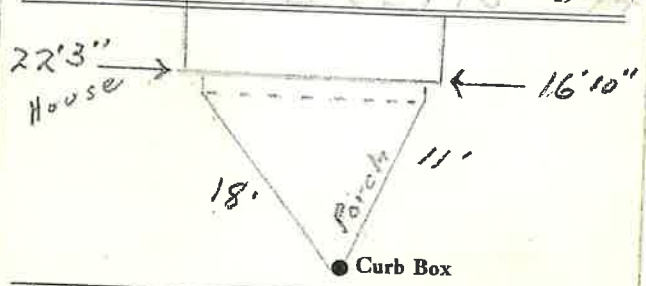

6" 1958 C.I.
Main Elev. of Main at tap 7.?

Gate at • Gate at

• Curb Box

This tap changed from old 4" galv. to New 6" main 1958