

Labor and Materials

1	Copper	Connection	3/4	\$	1.33
1	Curb	Cock Valve	3/4	\$	1.58
1	Service Box	Short 3 1/2 x 4 1/2		\$	1.36
	Old returned	Long 4 1/2 x 5 1/2		\$	
		Buff. or Rivet		\$	
7	Ft.	Copper Pipe at		\$	67
		Galv. Iron		\$	
		Cast Iron		\$	
	Nipples	in. at		\$	
	Bushings	to in. at		\$	
	Red'g Inc'g	Couplings to in. at		\$	
	Union	in. at		\$	
	Meter	in. at		\$	
	Lbs. Br. Stone	at		\$	
	Lbs. Sand	at		\$	
	Bags Cement	at		\$	
	Paving Brick	Mack Red Asphalt at		\$	
	Lead Joints	at		\$	
	Leadite Joints	at		\$	
2 1/4	Hrs. Foreman	at		\$	13.13
4	Hrs. Common Labor	at Tapper		\$	2
	Hrs. Common Labor	at		\$	
	Hrs. Mason	at		\$	
	Hrs. Masons Helper	at		\$	
	Hrs. Compressor	at		\$	
	Compensation Ins			\$	46
	Trucking			\$	9
	Builders Use of Water	2 holes		\$	1

Total \$ 30.53


33-51

#17

Labor and Material Report

July 20 1933

13 Auburn Place

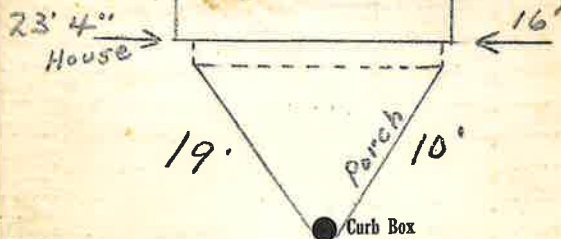

6" 1958
4 Main C.I.

Elev of Main at tap 5 1/2

Gate at ●

● Gate at

● Curb Box

old Tap shut off at Main

MAIN is between Curb & Side Walk

M