

LABOR AND MATERIALS


1 Copper } Connection 3/4" \$ _____
 Lead }
 1 Curb } Cook } 3/4 MARK II
 Valve } 3/4 in. ORISEAL \$ _____
 T.S. & V. }
 1 Service box { Short 3 1/2 x 4 1/2 }
 Old returned { Long 4 1/2 x 5 1/2 } \$ _____
 { Buff or Rdway }
59 Ft. 3/4 in. { Copper } Pipe at \$ _____
 { C.I. }
 { C.I. }
 Nipples in. at \$ _____
 Bushings to in. at \$ _____
 Red'g }
 Inc'g } Coupl'gs to in. at \$ _____
 Union in. at \$ _____
 Meter in. at \$ _____
 Lead Joints at \$ _____
 Compound Joints at \$ _____
 Maintenance Foreman \$ _____
 Hrs. Water Maint. Man-1 at \$ _____
 Hrs. Water Maint. Man-2 at \$ _____
 Hrs. Garage Foreman at \$ _____
 Hrs. Labor at \$ _____
 Hrs. Compressor at \$ _____
 Compensation Ins. at \$ _____ per C \$ _____
 Trucking \$ _____
 Pav't Patch \$ _____
Tap made by Peck \$ _____
St John April-21-1972 \$ _____
 O'head \$ _____

4th House Above Trailer Court

AVATION Road St. Pl. Ave. No. ?

Name of Owner
EUGENE FAIRCLOTH

Labor and Mat'l. Report April 21 1972

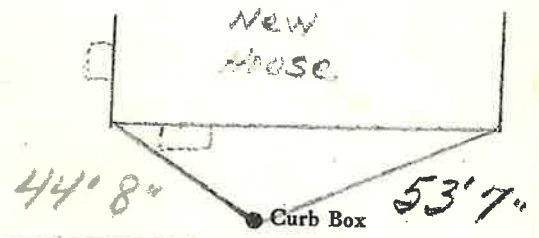

12\" Wilkie Main C.I. Elev. of Main at tap 4'

Gate at ● Gate at ●

● Curb Box