

33 1942

St.
Pl.
Ave. No.


Aviation Blvd

Name of Owner

Tucker

Labor and Mat'l. Report

June 1 1942

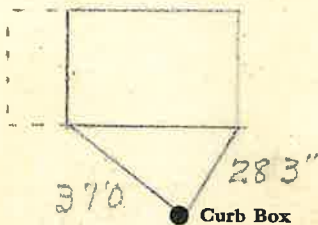

12 Main

Elev. of Main at tap 4 1/2

Gate at ●

● Gate at

● Curb Box

H.

LABOR AND MATERIALS

1	Copper	Connection	3/4	\$	1.35
1	Curb	Cock Valve T. S. & V.	3/4 in.	\$	1.88
1	Service Box	Short 3 1/2 x 4 1/2	}	\$	1.82
	Old returned	Long 4 1/2 x 5 1/2			
15	Ft.	3/4 in.	Copper Galv Iron Cast Iron	Pipe at 20	\$ 3.00
	Nipples	in. at		\$	
	Bushings	to in. at		\$	
	Red'g Inc'g	Couplings	to in. at	\$	
	Union	in. at		\$	
	Meter	in. at		\$	
	Lead Joints	at		\$	
	Leadite Joints	at		\$	
	Hrs. Foreman	at		\$	
2	Hrs. Chauffeur	at	68 3/4	\$	1.38
	Hrs. Tapper	at		\$	
2	Hrs. Labor	at	55	\$	1.10
	Hrs. Labor	at		\$	
	Hrs. Compressor	at		\$	
	Compensation Ins.			\$.08
	Trucking			\$	1.00
	Builders Use of Water	outside city		\$	
	Top by Miller			\$	
				\$	
				\$	
				\$	
				\$	
				\$	11.61

H.