

LABOR AND MATERIALS


Copper	} Connection	3/4	-----	\$ 135	
Lead					
Curb	} Cock Valve	3/4	in. -----	\$ 188	
					T. S. & V.
Service Box	} Short 3 1/2 x 4 1/2	}	-----	\$ 182	
Old returned					Long 4 1/2 x 5 1/2
					Buff. or Rdway
15 Ft.	} Copper	}	Pipe at 22¢ -----	\$ 3.00	
3/4 in.					Galv Iron
					Cast Iron
Nipples	in. at -----		\$		
Bushings	to ----- in. at -----		\$		
Red'g	} Couplings	to ----- in. at -----	\$		
Inc'g					
Union	in. at -----		\$		
Meter	in. at -----		\$		
Lead Joints	at -----		\$		
Leadite Joints	at -----		\$		
Hrs. Foreman	at -----		\$		
2 Hrs. Chauffeur	at 68 3/4 -----		\$ 1.39		
Hrs. Tapper	at -----		\$		
Hrs. Labor	at -----		\$		
Hrs. Labor	at -----		\$		
Hrs. Compressor	at -----		\$		
Compensation Ins.	-----		\$.05		
Trucking	-----		\$ 1.00		
Builders Use of Water	outside city -----		\$		
Tap by Miller	-----		\$		
Fifteen House on left	-----		\$		
Lead 3/4 in. from	-----		\$		
Work	-----		\$		
			\$ 10.48		

8 1942

St. _____
Pl. _____
Ave. No. _____

Name of Owner
Arthur Goldman

Labor and Mat'l. Report June 24 1942

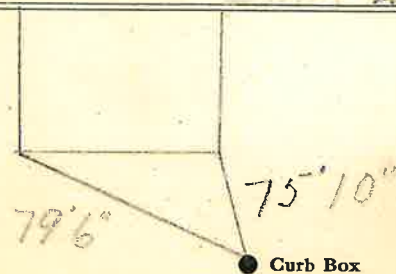

12 Main Elev. of Main at tap 4
Gate at ● Gate at ●

● Curb Box

Martin Ricketts