


LABOR AND MATERIALS

1	Copper	{ Connection	3/4"	\$	3.04
	Lead				
1	Curb	{ Cock Valve	3/4 in.	\$	3.54
		{ T.S. & V.			
1	Service box	{ Short 3 1/2 x 4 1/2		\$	4.70
	Old returned	{ Long 4 1/2 x 5 1/2			
		{ Buff or Rdway			
9	Ft.	{ Copper	3/4 in.	\$	3.15
		{ G.I.			
		{ C.I.			
	Nipples	in. at		\$	
	Bushings	to in. at		\$	
	Red'g	{ Coupl'gs	to in. at	\$	
	Inc'g				
	Union	in. at		\$	
	Meter	in. at		\$	
	Lead Joints at			\$	
	Compound Joints at			\$	
	Hrs. Water Maint. Man-1 at			\$	
2	Hrs. Water Maint. Man-2 at	1.13		\$	2.26
2	Hrs. Labor	at 102		\$	2.04
	Hrs. Labor	at		\$	
	Hrs. Compressor at			\$	
	Compensation Ins. at \$ 2.66 per C.			\$	11
	Trucking			\$	1.-
	Pav't Patch	Outside City		\$	
				\$	
				\$	
				\$	
	O'head			\$	
	Tap by Warsinski			\$	19.84
	6-12-51				

Str: _____
 PI: _____
 Ave. No. _____

Name of Owner
 Bertram Harvey

Labor and Mat'l. Report June 12 1951

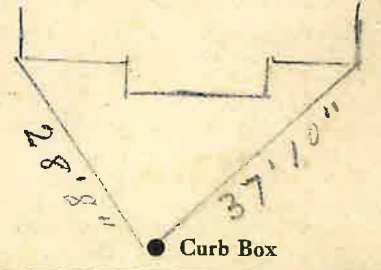

12" Main Elev. of Main at tap 5'
 Gate at ● Gate at ●

● Curb Box