

LABOR AND MATERIALS


1 Copper } Connection $\frac{3}{4}$ " \$
 Lead }
 1 Curb } Cock } $\frac{3}{4}$ in. Oriseal \$
 Valve }
 T. S. & V. }
 1 Service box { Short $3\frac{1}{2}$ x $4\frac{1}{2}$ }
 Old returned { Long $4\frac{1}{2}$ x $5\frac{1}{2}$ }
 { Buff or Rdway } \$
 46 Ft. $\frac{3}{4}$ in. { Copper } Pipe at \$
 { G. I. }
 { C. I. }
 Nipples in. at \$
 Bushings to in. at \$
 Red'g }
 Inc'g } Coupl'gs to in. at \$
 Union in. at \$
 Meter in. at \$
 Lead Joints at \$
 Compound Joints at \$
 Maintenance Foreman \$
 Hrs. Water Maint. Man-1 at \$
 Hrs. Water Maint. Man-2 at \$
 Hrs. Garage Foreman at \$
 Hrs. Labor at \$
 Hrs. Compressor at \$
 Compensation Ins. at \$ ^{yr} per C. \$
 Trucking \$
 Pav't Patch \$
 Tap by Domovari \$
 4 Harrah \$
 O'head 6-15-64. \$
 \$

Aviation

St. Rd.
 Pl.
 Ave. No.

Name of Owner Geo. Van Lur Linde
 3rd House Above Trailer Ct.

Labor and Mat'l. Report June 15 19 64.

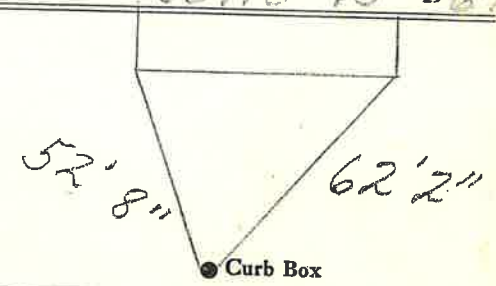

12" Wilkie Main C.I. Elev. of Main at tap 4'

Gate at ● Gate at ●

● Curb Box