


LABOR AND MATERIALS

1 Copper } Connection ³/₄ _____ \$ _____
 Lead } ⁴/₄
 1 Curb } Cock } ³/₄ in. _____ \$ _____
 } Valve }
 } T.S. & V. }
 1 Service box } Short 3 1/2 x 4 1/2 _____ \$ _____
 Old returned } Long 4 1/2 x 5 1/2 _____
 } Buff or Rdway }
 16 Ft. ³/₄ in. } Copper } Pipe at _____ \$ _____
 } G.I. }
 } G.I. }
 Nipples _____ in. at _____ \$ _____
 Bushings _____ to _____ in. at _____ \$ _____
 Red'g }
 Inc'g } Coupl'gs _____ to _____ in. at _____ \$ _____
 Union _____ in. at _____ \$ _____
 Meter _____ in. at _____ \$ _____
 Lead Joints at _____ \$ _____
 Compound Joints at _____ \$ _____
 Maintenance Foreman _____ \$ _____
 Hrs. Water Maint. Man—1 at _____ \$ _____
 Hrs. Water Maint. Man—2 at _____ \$ _____
 Hrs. Garage Foreman _____ at _____ \$ _____
 Hrs. Labor _____ at _____ \$ _____
 Hrs. Compressor at _____ \$ _____
 Compensation Ins. at \$ _____ per C _____ \$ _____
 Trucking _____ \$ _____
 Pay't Patch _____ \$ _____
 _____ \$ _____
 _____ \$ _____
 _____ \$ _____
 O'head _____ \$ _____
 _____ \$ _____

St. _____
 Ave. No. 1
BACON

Name of Owner
AMERICAN RED CROSS

Labor and Mat'l. Report 19

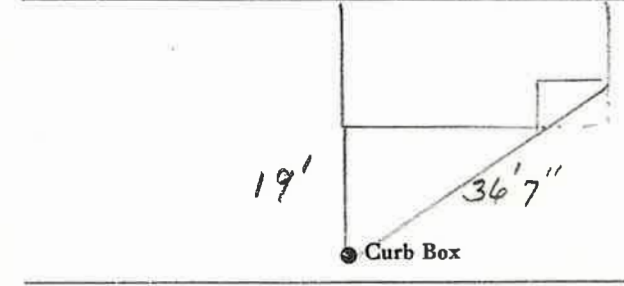

6" S-I Main Elev. of Main at tap 5

Gate at • • Gate at

TAX ID # 302.20-21-23

• Curb Box