

LABOR AND MATERIALS

1	Copper	} Connection $\frac{3}{4}$ "	\$
	Lead		
1	Curb	} Cock Valve } $\frac{3}{4}$ " in.	\$
			T.S. & V.
1	Service box	} Short $3\frac{1}{2}$ x $4\frac{1}{2}$ } } Long $4\frac{1}{2}$ x $5\frac{1}{2}$ } } Buff or Rdway }	\$
	Old returned		
16	Ft. $\frac{3}{4}$ in.	} Copper } } Pipe at }	\$
	Nipples	in. at	\$
	Bushings	to in. at	\$
	Red'g } Inc'g }	} Coupl'gs to in. at	\$
	Union		in. at
	Meter	in. at	\$
	Lead Joints	at	\$
	Compound Joints	at	\$
	Maintenance Foreman		\$
	Hrs. Water Maint. Man-1	at	\$
	Hrs. Water Maint. Man-2	at	\$
	Hrs. Garage Foreman	at	\$
	Hrs. Labor	at	\$
	Hrs. Compressor	at	\$
	Compensation Ins. at \$	per C	\$
	Trucking		\$
	Pav't Patch		\$
			\$
			\$
	O'head		\$
			\$

BACON


St. ~~Pl.~~
Ave. No. 15

Name of Owner

TAX ID # 302.20-21-17

Labor and Mat'l. Report

19

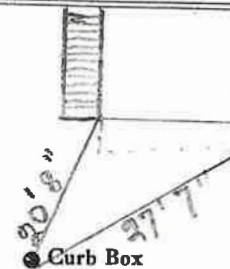

6" Main

Elev. of Main at tap 5'

Gate at ●

● Gate at

● Curb Box