


LABOR AND MATERIALS

1	Copper	} Connection $\frac{3}{4}$	\$
	Lead		
1	Curb	} $\frac{3}{4}$ in.	\$
	Cock		
	Valve T.S. & V.		
1	Service box	{ Short $3\frac{1}{2} \times 4\frac{1}{2}$	\$
	Old returned		
		{ Buff or Rdway	
17	Ft. $\frac{3}{4}$ in.	{ Copper	\$
		{ C.I.	
		} Pipe at	
	Nipples	in. at	\$
	Bushings	to in. at	\$
	Red'g	} Coupl'gs to in. at	\$
	Inc'g		
	Union	in. at	\$
	Meter	in. at	\$
	Lead Joints	at	\$
	Compound Joints	at	\$
	Maintenance Foreman		\$
	Hrs. Water Maint. Man-1	at	\$
	Hrs. Water Maint. Man-2	at	\$
	Hrs. Garage Foreman	at	\$
	Hrs. Labor	at	\$
	Hrs. Compressor	at	\$
	Compensation Ins.	at \$ per C	\$
	Trucking		\$
	Pav't Patch		\$
			\$
			\$
	O'head		\$
			\$

St. BACON Ave. No. 17

Name of Owner _____
TAX ID # 302.20-21-16

Labor and Mat'l. Report 19

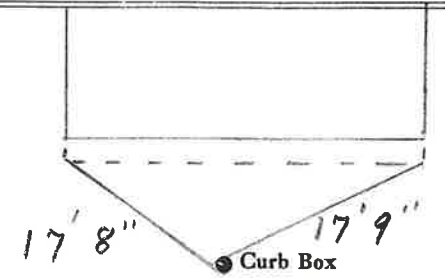

6 Main Elev. of Main at tap 5

Gate at • • Gate at

● Curb Box