

LABOR AND MATERIALS

1	Copper	} Connection	_____	\$	_____	
	Lead					
1	Curb	} Cock Valve T.S. & V.	_____ in.	\$	_____	
1	Service box	} Short 3 1/2 x 4 1/2 Long 4 1/2 x 5 1/2 Buff or Rdway	_____	\$	_____	
	Old returned					
18	Ft. 3/4 in.	} Copper G.I. C.I.	Pipe at 3/4	\$	_____	
	Nipples	in. at	_____	\$	_____	
	Bushings	to _____ in. at	_____	\$	_____	
	Red'g } Inc'g }	Coupl'gs	to _____ in. at	\$	_____	
	Union	in. at	_____	\$	_____	
	Meter	in. at	_____	\$	_____	
	Lead Joints	at	_____	\$	_____	
	Compound Joints	at	_____	\$	_____	
	Maintenance Foreman		_____	\$	_____	
	Hrs. Water Maint. Man-1	at	_____	\$	_____	
	Hrs. Water Maint. Man-2	at	_____	\$	_____	
	Hrs. Garage Foreman	at	_____	\$	_____	
	Hrs. Labor	at	_____	\$	_____	
	Hrs. Compressor	at	_____	\$	_____	
	Compensation Ins. at \$	per C	_____	\$	_____	
	Trucking		_____	\$	_____	
	Pav't Patch		_____	\$	_____	
			_____	\$	_____	
			_____	\$	_____	
	O'head		_____	\$	_____	
			_____	\$	_____	


*W*

BACON

St. Pl. Ave. No. 3

Name of Owner  
TAX ID # 302.20-21-22

Labor and Mat'l. Report 19

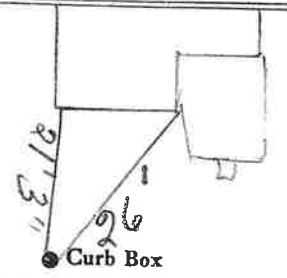

Main Elev. of Main at tap  
Gate at • Gate at

18' to main

• Curb Box