


LABOR AND MATERIALS

1	Copper Lead	Connection	3/4	\$	
1	Curb	Cock Valve T.S. & V.	3/4 in.	\$	
1	Service box Old returned	Short 3 1/2 x 4 1/2 Long 4 1/2 x 5 1/2 Buff or Rdway		\$	
8	Ft.	3/4 in.	Copper G.I. G.I.	Pipe at	\$
	Nipples	in.		at	\$
	Bushings	to	in.	at	\$
	Red'g Inc'g	Coupl'gs	to	in.	at \$
	Union	in.		at	\$
	Meter	in.		at	\$
	Lead Joints	at			\$
	Compound Joints	at			\$
	Maintenance Foreman				\$
	Hrs. Water Maint. Man-1	at			\$
	Hrs. Water Maint. Man-2	at			\$
	Hrs. Garage Foreman	at			\$
	Hrs. Labor	at			\$
	Hrs. Compressor	at			\$
	Compensation Ins.	at \$	per C		\$
	Trucking				\$
	Pav't Patch				\$
					\$
					\$
					\$
	O'head				\$
					\$

St. BACON
 Pl. 8
 Ave. No. 8
 Name of Owner _____
 TAX ID # 302.20-22-12

Labor and Mat'l. Report 19

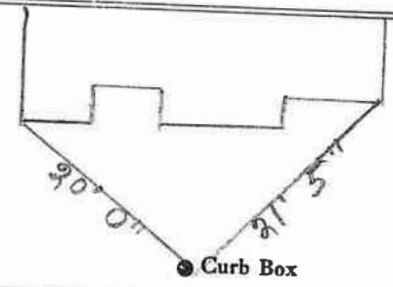

6" Main Elev. of Main at tap 5
 Gate at ● ● Gate at

● Curb Box