

LABOR AND MATERIALS

1 Copper } Connection _____ \$
 Lead }
 1 Curb } Cock Valve } _____ in. \$
 T.S. & V. }
 1 Service box } Short 3 1/2 x 4 1/2 }
 Old returned } Long 4 1/2 x 5 1/2 }
 Buff or Rdway } _____ \$
 16 Ft. 3/4 in. } Copper } Pipe at _____ \$
 C.I. }
 C.I. }
 Nipples _____ in. at _____ \$
 Bushings _____ to _____ in. at _____ \$
 Red'g }
 Inc'g } Coupl'gs _____ to _____ in. at _____ \$
 Union _____ in. at _____ \$
 Meter _____ in. at _____ \$
 Lead Joints at _____ \$
 Compound Joints at _____ \$
 Maintenance Foreman _____ \$
 Hrs. Water Maint. Man-1 at _____ \$
 Hrs. Water Maint. Man-2 at _____ \$
 Hrs. Garage Foreman _____ at _____ \$
 Hrs. Labor- _____ at _____ \$
 Hrs. Compressor at _____ \$
 Compensation Ins. at \$ _____ per C _____ \$
 Trucking _____ \$
 Pav't Patch _____ \$
 _____ \$
 _____ \$
 _____ \$
 O'head _____ \$
 _____ \$

BACON


St. _____
 Pl. _____
 Ave. No. 9

Name of Owner _____

TAX ID # 302.20-21-19

Labor and Mat'l. Report

19

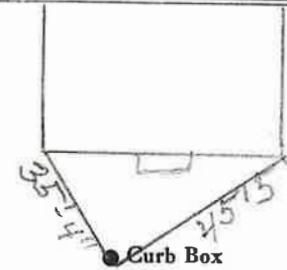

2 1/2" Main

Elev. of Main at tap 6'

Gate at ●

● Gate at

● Curb Box