

LABOR AND MATERIALS

1	Copper Lead	} Connection	3/4	\$	
1	Curb			} 3/4 in.	\$
1	Service box Old returned	} [Short 3 1/2 x 4 1/4 Long 4 1/2 x 5 1/2 Buf. or Rdway]		\$	
12	Ft. 3/4 in.		} [Copper G.I. C.I.]	Pipe at	\$
	Nipples	in. at		\$	
	Bushings	to in. at		\$	
	Red'g Inc'g	} Coupl'gs	to in. at	\$	
	Union		in. at		\$
	Meter	in. at		\$	
	Lead Joints at			\$	
	Compound Joints at			\$	
	Maintenance Foreman			\$	
	Hrs. Water Maint. Man—1 at			\$	
	Hrs. Water Maint. Man—2 at			\$	
	Hrs. Garage Foreman	at		\$	
	Hrs. Labor—	at		\$	
	Hrs. Compressor at			\$	
	Compensation Ins. at \$	per C		\$	
	Trucking			\$	
	Pav't Patch			\$	
				\$	
				\$	
	O'head			\$	
				\$	


St. BALDWIN
Pl. 32
Ave. No. 32

Name of Owner

TAX ID # 302.12-13-47

Labor and Mat'l. Report

19 81

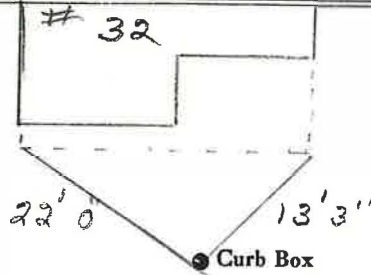

6" Main Elev. of Main at tap 6'
Gate at ● ● Gate at

● Curb Box