


LABOR AND MATERIALS

1	Copper	} Connection <u>3/4</u>	\$
	Lead		
1	Curb	} Cock Valve T.S. & V.	\$
			in.
1	Service box	} Short 3 1/2 x 4 1/2 Long 4 1/2 x 5 1/2 Buff or Rdway	\$
	Old returned		
11	Ft. <u>3/4</u> in.	} Copper C.I. C.I.	\$
			Pipe at
	Nipples	in. at	\$
	Bushings	to in. at	\$
	Red'g	} Coupl'gs to in. at	\$
	Inc'g		
	Union	in. at	\$
	Meter	in. at	\$
	Lead Joints at		\$
	Compound Joints at		\$
	Maintenance Foreman		\$
	Hrs. Water Maint. Man-1 at		\$
	Hrs. Water Maint. Man-2 at		\$
	Hrs. Garage Foreman at		\$
	Hrs. Labor at		\$
	Hrs. Compressor at		\$
	Compensation Ins. at \$	per C	\$
	Trucking		\$
	Pav't Patch		\$
			\$
			\$
	O'head		\$
			\$

BALDWIN St. Pl. Ave. No. 36

Name of Owner
TAX ID # 302.12-13-49

Labor and Mat'l. Report 19 81

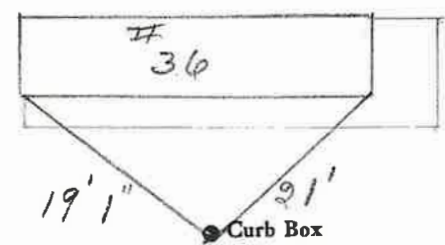

Main Elev. of Main at tap
Gate at • Gate at

• Curb Box