

LABOR AND MATERIALS

Copper	} Connection	_____	\$ _____		
Lead					
Curb	} Cock Valve T. S. & V.	} _____ in.	\$ _____		
				} Service box	} Short 3½ x 4½
			\$ _____		
Ft. <u>3/4</u> in.	} Copper C.I. C.I.	} Pipe at	\$ _____		
Nipples _____ in. at				\$ _____	
Bushings _____ to _____ in. at				\$ _____	
Red'g } Inc'g }	} Coupl'gs	} to _____ in. at	\$ _____		
Union _____ in. at				\$ _____	
Meter _____ in. at			\$ _____		
			\$ _____		
Compound Joints at			\$ _____		
Maintenance Foreman			\$ _____		
Hrs. Water Maint. Man—1 at			\$ _____		
Hrs. Water Maint. Man—2 at			\$ _____		
Hrs. Garage Foreman _____ at			\$ _____		
Hrs. Labor— _____ at			\$ _____		
Hrs. Compressor at			\$ _____		
			\$ _____		
Trucking _____			\$ _____		
Pav't Patch _____			\$ _____		
			\$ _____		
			\$ _____		
			\$ _____		

Baldwin


St. \_\_\_\_\_  
Pl. \_\_\_\_\_  
Ave. No. 38

Name of Owner

J. Brewer

Labor and Mat'l. Report

19 88

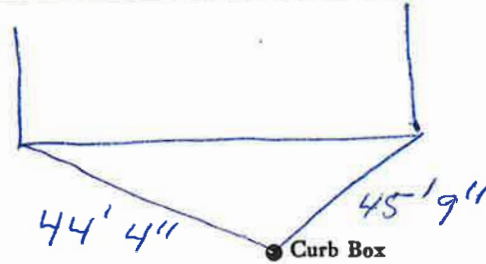

	Main	Elev. of Main at tap
Gate at •		• Gate at
		• Curb Box

TAX ID # 302.12-13-50