

LABOR AND MATERIALS


Copper } Connection _____	\$ _____
Lead } _____	
Curb } Cock	} _____ in. _____ \$ _____
} Valve	
} T. S. & V.	
Service box } Short 3½ x 4½	} _____ \$ _____
Old returned } Long 4½ x 5½	
} Buff or Rdway	
Ft. _____ in. } Copper	} Pipe at _____ \$ _____
} G. I.	
} C. I.	
Nipples _____ in. at _____	\$ _____
Bushings _____ to _____ in. at _____	\$ _____
Red'g } Coupl'gs _____ to _____ in. at _____	\$ _____
Inc'g }	
Union _____ in. at _____	\$ _____
Meter _____ in. at _____	\$ _____
Lead Joints at _____	\$ _____
Compound Joints at _____	\$ _____
Maintenance Foreman _____	\$ _____
Hrs. Water Maint. Man—1 at _____	\$ _____
Hrs. Water Maint. Man—2 at _____	\$ _____
Hrs. Garage Foreman _____ at _____	\$ _____
Hrs. Labor— _____ at _____	\$ _____
Hrs. Compressor at _____	\$ _____
Compensation Ins. at \$ _____ per C _____	\$ _____
Trucking _____	\$ _____
Pav't Patch _____	\$ _____
_____	\$ _____
_____	\$ _____
_____	\$ _____
O'head _____	\$ _____
_____	\$ _____

St. _____
Pl. _____
Ave. No. 46

BALDWIN

Name of Owner _____
TAX ID # 302.12-13-54

Labor and Mat'l. Report 19 81

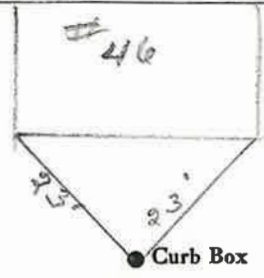

Main Elev. of Main at tap _____

Gate at ● ● Gate at

● Curb Box