

LABOR AND MATERIALS

Copper	}	Connection		\$	
Lead					
Curb	}	Cock	in.	\$	
		Valve			
		T. S. & V.			
Service box	}	Short 3½ x 4½		\$	
Old returned		Long 4½ x 5½			
		Buff or Rdway			
Ft.	}	Copper	Pipe at	\$	
in.		G. I.			
		C. I.			
Nipples		in. at		\$	
Bushings		to in. at		\$	
Red'g	}	Coupl'gs	to in. at	\$	
Inc'g					
Union		in. at		\$	
Meter		in. at		\$	
Lead Joints at				\$	
Compound Joints at				\$	
Maintenance Foreman				\$	
Hrs. Water Maint. Man—1 at				\$	
Hrs. Water Maint. Man—2 at				\$	
Hrs. Garage Foreman at				\$	
Hrs. Labor— at				\$	
Hrs. Compressor at				\$	
Compensation Ins. at \$		per C		\$	
Trucking				\$	
Pav't Patch				\$	
				\$	
				\$	
				\$	
O'head				\$	
				\$	

BALDWIN


St.
Pl.
Ave. No. 47

Name of Owner

TAX ID # 302.12-16-2

Labor and Mat'l. Report

19 81

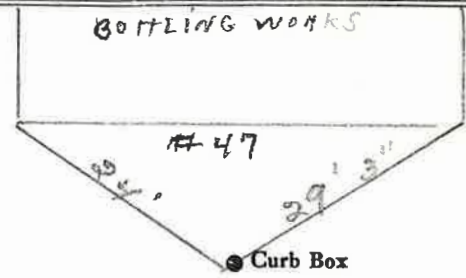

Main

Elev. of
Main at tap

Gate at ●

● Gate at

● Curb Box

