

LABOR AND MATERIALS


1	Copper Lead	} Connection	3/4"	\$
1	Curb			} Cock Valve T.S. & V.
1	Service box	} Short 3 1/2 x 4 1/2	}	
	Old returned			Long 4 1/2 x 5 1/2
20	Ft. 3/4 in.	} Copper	}	\$
	Nipples	in. at	\$	
	Bushings	to in. at	\$	
	Red'g	} Coupl'gs	to in. at	\$
	Inc'g			
	Union	in. at	\$	
	Meter	in. at	\$	
	Lead Joints at	\$		
	Compound Joints at	\$		
	Maintenance Foreman	\$		
	Hrs. Water Maint. Man-1 at	\$		
	Hrs. Water Maint. Man-2 at	\$		
	Hrs. Garage Foreman at	\$		
	Hrs. Labor at	\$		
	Hrs. Compressor at	\$		
	Compensation Ins. at \$	per C	\$	
	Trucking	\$		
	Pav't Patch	\$		
	O'head	\$		

BALDWIN

St. Pl. Ave. No. 49

Name of Owner
TAX ID # 302.12-16-1

Labor and Mat'l. Report 1981

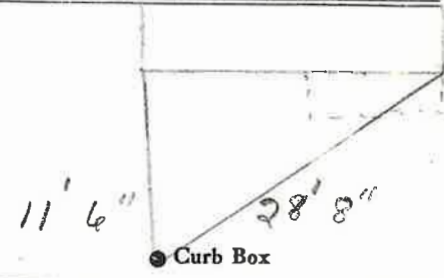

6" Main Elev. of Main at tap 5'

Gate at • Gate at •
20' to main
• Curb Box

