


LABOR AND MATERIALS

1	Copper	} Connection <u>3/4</u>	\$
	<del>Lead</del>		
1	Curb	} Cock Valve } <u>3/4</u> in.	\$
			T.S. & V.
1	Service box	} Short $3\frac{1}{2} \times 4\frac{1}{2}$	\$
	Old returned		} Long $4\frac{1}{2} \times 5\frac{1}{2}$
			} Buff. or Rdway
9	Ft. <u>3/4</u> in.	} Copper	\$
			} C.I.
		} Pipe at	\$
	Nipples	in. at	\$
	Bushings	to in. at	\$
	Red'g		\$
	Inc'g	Coupl'gs to in. at	\$
	Union	in. at	\$
	Meter	in. at	\$
	Lead Joints	at	\$
	Compound Joints	at	\$
	Maintenance Foreman		\$
	Hrs. Water Maint. Man-1	at	\$
	Hrs. Water Maint. Man-2	at	\$
	Hrs. Garage Foreman	at	\$
	Hrs. Labor	at	\$
	Hrs. Compressor	at	\$
	Compensation Ins.	at \$ per C	\$
	Trucking		\$
	Pav't Patch		\$
			\$
			\$
	O'head		\$
			\$

BALDWIN St. Pl. Ave. No. 50

Name of Owner  
TAX ID # 302.12-13-56

Labor and Mat'l. Report 19

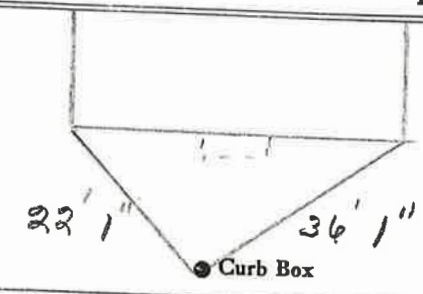

6'' Main Elev. of Main at tap 5'

Gate at ● ● Gate at

● Curb Box