

LABOR AND MATERIALS


1	Copper	}	Connection	_____	\$	
	Lead					
1	Curb	}	Cock	_____ in.	\$	
			Valve			
			T.S. & V.			
1	Service box	}	Short 3½ x 4½	_____	\$	
	Old returned		Long 4½ x 5½			
			Buff or Rdway			
11	Ft. ¾ in.	}	Copper	Pipe at _____	\$	
			C.I.			
			C.I.			
	Nipples		in. at _____	\$		
	Bushings		to _____ in. at _____	\$		
	Red'g	}	Coupl'gs	to _____ in. at _____	\$	
	Inc'g					
	Union		in. at _____	\$		
	Meter		in. at _____	\$		
	Lead Joints at _____			\$		
	Compound Joints at _____			\$		
	Maintenance Foreman _____			\$		
	Hrs. Water Maint. Man—1 at _____			\$		
	Hrs. Water Maint. Man—2 at _____			\$		
	Hrs. Garage Foreman _____ at _____			\$		
	Hrs. Labor— _____ at _____			\$		
	Hrs. Compressor at _____			\$		
	Compensation Ins. at \$ _____ per C			\$		
	Trucking _____			\$		
	Pav't Patch _____			\$		
	_____			\$		
	_____			\$		
	_____			\$		
	O'head _____			\$		
	_____			\$		

~~St.~~
~~Pl.~~
Ave. No. 54

BALDWIN
Name of Owner

TAX ID # 302.12-13-58

Labor and Mat'l. Report 19 81

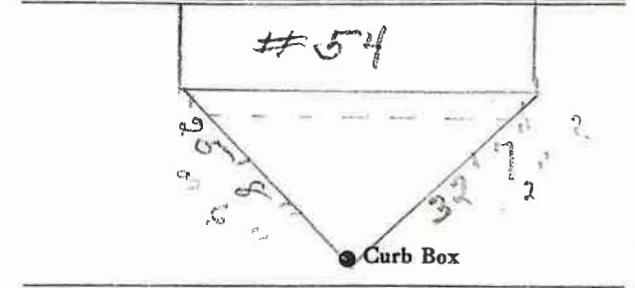

Main Elev. of
Main at tap

Gate at ● ● Gate at

● Curb Box