


LABOR AND MATERIALS

1	Copper	} Connection	3/4	_____	\$ _____
	Lead				
1	Curb	} Cock Valve T.S. & V.	3/4 in.	_____	\$ _____
1	Service box	} Short 3 1/2 x 4 1/2 Long 4 1/2 x 5 1/2 Buff or Rdway		_____	\$ _____
	Old returned				
9	Ft. 3/4 in.	} Copper G.I. C.I.		Pipe at _____	\$ _____
	Nipples	in. at _____			\$ _____
	Bushings	to _____ in. at _____			\$ _____
	Red'g } Inc'g }	Coupl'gs to _____ in. at _____			\$ _____
	Union	in. at _____			\$ _____
	Meter	in. at _____			\$ _____
	Lead Joints	at _____			\$ _____
	Compound Joints	at _____			\$ _____
	Maintenance Foreman	_____			\$ _____
	Hrs. Water Maint. Man-1	at _____			\$ _____
	Hrs. Water Maint. Man-2	at _____			\$ _____
	Hrs. Garage Foreman	at _____			\$ _____
	Hrs. Labor-	at _____			\$ _____
	Hrs. Compressor	at _____			\$ _____
	Compensation Ins. at \$ _____	per C _____			\$ _____
	Trucking	_____			\$ _____
	Pav't Patch	_____			\$ _____
		_____			\$ _____
		_____			\$ _____
	O'head	_____			\$ _____
		_____			\$ _____

BALOWIN St. Pl. Ave. No. 56

Name of Owner
TAX ID # 302.12-13-59

Labor and Mat'l. Report 19 81

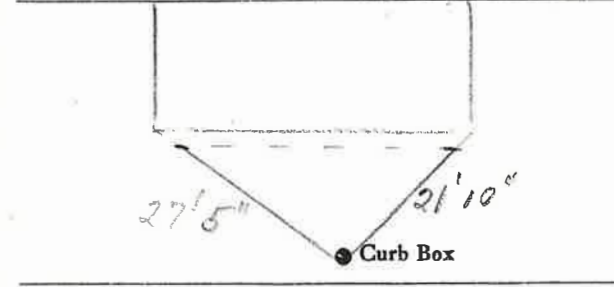

6" Main Elev. of Main at tap 5'

Gate at • Gate at •

• Curb Box