


LABOR AND MATERIALS

1	Copper	} Connection	3/4	\$
	Lead			
1	Curb	} T. S. & V.	3/4 in.	\$
	Cock			
	Valve			
1	Service box	} Short 3 1/2 x 4 1/2		\$
	Old returned			
11	Ft. 3/4 in.	} Copper	Pipe at	\$
	Nipples	in. at	\$	
	Bushings	to in. at	\$	
	Red'g	} Coupl'gs	to in. at	\$
	Inc'g			
	Union	in. at	\$	
	Meter	in. at	\$	
	Lead Joints	at	\$	
	Compound Joints	at	\$	
	Maintenance Foreman		\$	
	Hrs. Water Maint. Man-1	at	\$	
	Hrs. Water Maint. Man-2	at	\$	
	Hrs. Garage Foreman	at	\$	
	Hrs. Labor	at	\$	
	Hrs. Compressor	at	\$	
	Compensation Ins. at \$	per C	\$	
	Trucking		\$	
	Pav't Patch		\$	
			\$	
			\$	
			\$	
	O'head		\$	
			\$	

St. Pl. Ave. No. 20
BALDWIN

Name of Owner
 TAX ID # 302.12-13-41

Labor and Mat'l. Report 1981

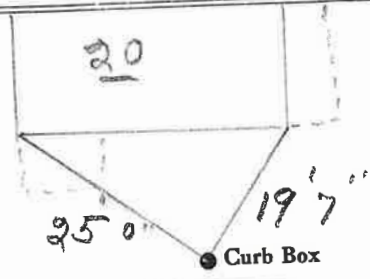

6 Main Elev. of Main at tap 5 1/2
 Gate at • Gate at •

• Curb Box