

LABOR AND MATERIALS


Copper	} Connection <sup>3/4</sup>	_____	\$ _____
Lead			
Curb	} Cock Valve T. S. & V. <sup>3/4 in.</sup>	_____	\$ _____
1 Service box	{ Short 3 1/2 x 4 1/2 Long 4 1/2 x 5 1/2 }	_____	\$ _____
Old returned			
7 Ft. <sup>3/4</sup> in.	{ Copper G. I. C. I. }	Pipe at _____	\$ _____
Nipples	in. at _____		\$ _____
Bushings	to _____ in. at _____		\$ _____
Red'g	} Coupl'gs _____ to _____ in. at _____		\$ _____
Inc'g			
Union	in. at _____		\$ _____
Meter	in. at _____		\$ _____
Compound Joints	at _____		\$ _____
Maintenance Foreman			\$ _____
Hrs. Water Maint. Man—1	at _____		\$ _____
Hrs. Water Maint. Man—2	at _____		\$ _____
Hrs. Garage Foreman	at _____		\$ _____
Hrs. Labor—	at _____		\$ _____
Hrs. Compressor at	_____		\$ _____
Trucking	_____		\$ _____
Pav't Patch	_____		\$ _____
			\$ _____
			\$ _____
BASIN

St. ~~Pr.~~ Ave. No. 14

Name of Owner \_\_\_\_\_

Labor and Mat'l. Report SEPT. 19 26

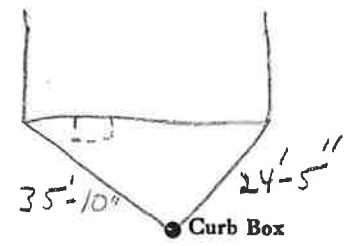

6" Main

Elev. of Main at tap \_\_\_\_\_

Gate at • • Gate at

• Curb Box

SHUT OFF AT CURB  
JULY 16, 1973