

LABOR AND MATERIALS

1	Copper Lead	Connection	3/4"	\$
1	Curb	Cook Valve T.S. & V.	3/4 in.	\$
	Service box	Short 3 1/2 x 4 1/2		
	Old returned	Long 4 1/2 x 5 1/2		
		Buff or Rdway		\$
21	Ft. 3/4 in.	Copper G.I. C.I.	Pipe at	\$
	Nipples	in. at		\$
	Bushings	to in. at		\$
	Red'g Inc'g	Coupl'gs to in. at		\$
	Union	in. at		\$
	Meter	in. at		\$
	Lead Joints at			\$
	Compound Joints at			\$
	Maintenance Foreman			\$
	Hrs. Water Maint. Man	1 at		\$
	Hrs. Water Maint. Man	2 at		\$
2	Hrs. <del>Charge</del> Foreman	PER 1"		\$
2	Hrs. Labor	at		\$
	Hrs. Compressor at			\$
	Compensation Ins. at \$	per C.		\$
	Trucking			\$
	Pav't Patch			\$
	O'head			\$

BASIN ST


St. 17  
Pl. 45  
Ave. No. 45

Name of Owner

Adirondack Dist Co Inc.

Measured in Nov. 14-55

Labor and Mat'l. Report Aug 29 1925

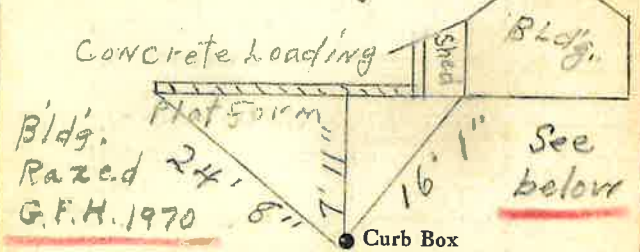


BASIN ST. (Hill)

Main

Elev. of Main at tap

Gate at • This Tap at one Time Gate at •

Went to 15 Basin St.

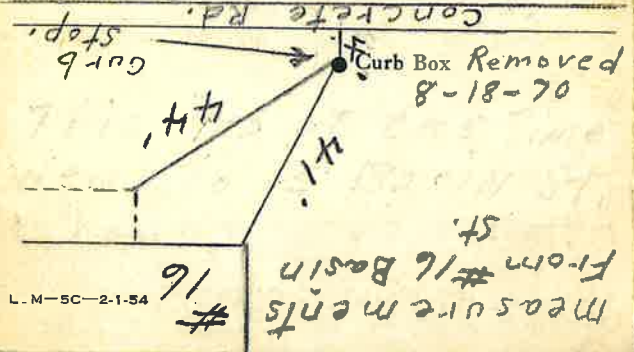

L.M-5C-2-1-54