


LABOR AND MATERIALS

1	Copper	} Connection $\frac{3}{4}$		\$
	Lead			
1	Curb	} Cock Valve T.S. & V.	} $\frac{3}{4}$ in.	\$
1	Service box			} Short $3\frac{1}{2} \times 4\frac{1}{2}$ Long $4\frac{1}{2} \times 5\frac{1}{2}$ Bolt or Rdway
	Old returned			
9'	Ft. $\frac{3}{4}$ in.	} Copper C.I. C.I.	} Pipe at	\$
	Nipples			
	Bushings	in. at	\$	
	Red'g	to in. at	\$	
	Inc'g	Coupl'gs. to in. at	\$	
	Union	in. at	\$	
	Meter	in. at	\$	
	Lead Joints	at	\$	
	Compound Joints	at	\$	
	Maintenance Foreman		\$	
	Hrs. Water Maint. Man-1	at	\$	
	Hrs. Water Maint. Man-2	at	\$	
	Hrs. Garage Foreman	at	\$	
	Hrs. Labor	at	\$	
	Hrs. Compressor	at	\$	
	Compensation Ins. at \$	per C	\$	
	Trucking		\$	
	Pav't Patch		\$	
	O'head		\$	

St. Pt. Ave. No. 174
BAY
 Name of Owner
A-THOMAS 2ST.

Labor and Mat'l. Report 19

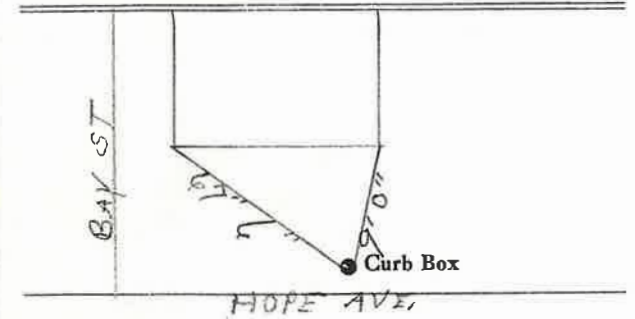

6 Main Elev. of Main at tap $5\frac{1}{2}$

Gate at • Gate at •

TAX ID # 302.16-6-12

• Curb Box
 TAP ON HOPE AVE,