


LABOR AND MATERIALS

1	Copper Lead	Connection	3/4	\$
1	Curb	Cock Valve T.S. & V.	in. 3/4	\$
1	Service box Old returned	Short 3 1/2 x 4 1/2 Long 4 1/2 x 5 1/2 Buff or Rdway		\$
13	Ft. in.	Copper G.I. G.I.	Pipe at	\$
	Nipples	in. at		\$
	Bushings	to in. at		\$
	Red'g Inc'g	Coupl'gs to in. at		\$
	Union	in. at		\$
	Meter	in. at		\$
	Lead Joints	at		\$
	Compound Joints	at		\$
	Maintenance Foreman			\$
	Hrs. Water Maint. Man-1	at		\$
	Hrs. Water Maint. Man-2	at		\$
	Hrs. Garage Foreman	at		\$
	Hrs. Labor	at		\$
	Hrs. Compressor	at		\$
	Compensation Ins.	at \$ per C		\$
	Trucking			\$
	Pav't Patch			\$
				\$
				\$
	O'head			\$
				\$

BAY
 St. Pl. Ave. No. 175
 Name of Owner
 TAX ID # 302.12-18-12

Labor and Mat'l. Report 19

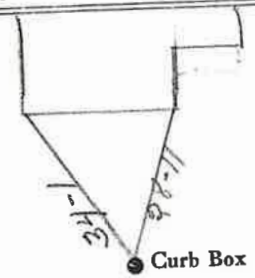

6 Main Elev. of Main at tap 5 1/2
 Gate at • Gate at •

OLD TAP DISCONNECTED • Curb Box