

LABOR AND MATERIALS


1	Copper Lead	} Connection		\$	
1	Curb	} Cock Valve T.S. & V.	in.	\$	
1	Service box Old returned	{ Short 3 1/2 x 4 1/2 Long 4 1/2 x 5 1/2 Buff or Rdway		\$	
15	Ft. 3/4 in.	{ Copper G.I. G.I.	Pipe at	\$	
	Nipples	in. at		\$	
	Bushings	to in. at		\$	
	Red'g Inc'g	Coupl'gs. to in. at		\$	
	Union	in. at		\$	
	Meter	in. at		\$	
	Lead Joints at			\$	
	Compound Joints at			\$	
	Maintenance Foreman			\$	
	Hrs. Water Maint. Man-1 at			\$	
	Hrs. Water Maint. Man-2 at			\$	
	Hrs. Garage Foreman at			\$	
	Hrs. Labor— at			\$	
	Hrs. Compressor at			\$	
	Compensation Ins. at \$	per C		\$	
	Trucking			\$	
	Pav't Patch			\$	
				\$	
				\$	
	O'head			\$	
				\$	

St. PT
Ave. No. 177

GAY

Name of Owner
TAX ID # 302.12-18-11

Labor and Mat'l. Report 19

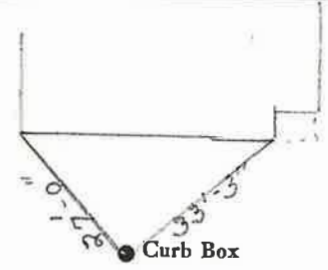

6¹¹ Main Elev. of Main at tap 4

Gate at ● ● Gate at

OLD TAP ● Curb Box
SHUT OFF