

LABOR AND MATERIALS

| | | | | | |
|---|-----------------------|--|-----------|----|--|
| 1 | Copper | Connection | | \$ | |
| | Lead | Cock Valve } T.S. & V. } | 1 in. | \$ | |
| 1 | Curb | | | | |
| 1 | Service box | Short 3 1/2 x 4 1/2 } Long 4 1/2 x 5 1/2 } Buff or Rdway } | | | |
| | Old returned | | | | |
| 8 | Ft. / in. | Copper } C.I. } | Pipe at | \$ | |
| | | | | | |
| | Nipples | in. at | | \$ | |
| | Bushings | to in. at | | \$ | |
| | Red'g } Inc'g } | Coupl'gs | to in. at | \$ | |
| | Union | | | | |
| | Meter | in. at | | \$ | |
| | Lead Joints | at | | \$ | |
| | Compound Joints | at | | \$ | |
| | Maintenance Foreman | | | \$ | |
| | Hrs. Water Maint. Man | 1 at | | \$ | |
| | Hrs. Water Maint. Man | 2 at | | \$ | |
| | Hrs. Garage Foreman | at | | \$ | |
| | Hrs. Labor | at | | \$ | |
| | Hrs. Compressor | at | | \$ | |
| | Compensation Ins. | at \$ | per C | \$ | |
| | Trucking | | | \$ | |
| | Pav't Patch | | | \$ | |
| | | | | \$ | |
| | | | | \$ | |
| | O'head | | | \$ | |


BAY

St. ~~Pl.~~
Ave. No. 183

Name of Owner

KNOBLAUCH CHAS. E

Labor and Mat'l. Report APRIL 14 1935

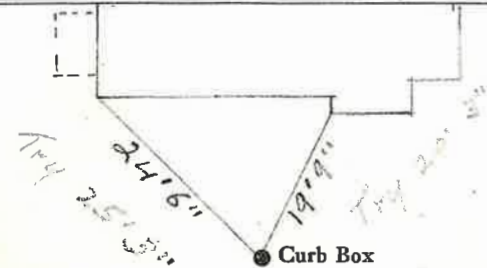

TAP ON MASON ST.

6 Main

Elev. of Main at tap 4 1/2'

Gate at ●

● Gate at

TAX ID # 302.12-18-8

● Curb Box

Lead Gowneck.
1" Iron Pipe

LABOR AND MATERIALS

| | | | | | |
|-----------------------------|---|------------------------------|---------|--|----|
| Copper | } | Connection | | | \$ |
| Lead | | | | | |
| Curb | } | Cock Valve | | | \$ |
| | | T. S. & V. | | | \$ |
| Service Box | | | | | |
| Old returned | } | Short 3 1/2 x 4 1/2 | | | \$ |
| | | Long 4 1/2 x 5 1/2 | | | \$ |
| | | Buff. or Rdway | | | \$ |
| Ft. _____ in. | } | Copper | Pipe at | | \$ |
| | | Galv Iron | | | \$ |
| | | Cast Iron | | | \$ |
| Nipples _____ in. | | at | | | \$ |
| Bushings _____ to _____ in. | | at | | | \$ |
| Red'g Inc'g | } | Couplings _____ to _____ in. | at | | \$ |
| | | | | | |
| Union _____ in. | | at | | | \$ |
| Meter _____ in. | | at | | | \$ |
| Lead Joints | | at | | | \$ |
| Leadite Joints | | at | | | \$ |
| Hrs. Foreman | | at | | | \$ |
| Hrs. Chauffeur | | at | | | \$ |
| Hrs. Tapper | | at | | | \$ |
| Hrs. Labor | | at | | | \$ |
| Hrs. Labor | | at | | | \$ |
| Hrs. Compressor | | at | | | \$ |
| Compensation Ins. | | | | | \$ |
| Trucking | | | | | \$ |
| Builders Use of Water | | | | | \$ |
| | | | | | \$ |
| | | | | | \$ |
| | | | | | \$ |
| | | | | | \$ |


St.
Pt.

Bay

Ave. No. *183*

Name of Owner

Labor and Mat'l. Report *Aug. 17* 19*39*

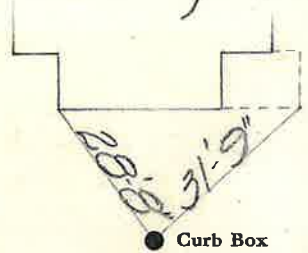

| | | |
|-----------|-------------|-----------|
| | Elev. of | |
| Main | Main at tap | |
| Gate at ● | | ● Gate at |

● Curb Box

*OLD BUFFALO BOX
ON BAY ST.*

3-22-00 - Couldn't find box - may have been removed