


LABOR AND MATERIALS

| | | | | | |
|----|-----------------------------|--|----------------|--------------------|----|
| 1 | Copper Lead | Connection | <u>3/4</u> | | \$ |
| 1 | Curb | Cock Valve T.S. & V. | <u>3/4</u> in. | | \$ |
| 1 | Service box Old returned | Short $3\frac{1}{2} \times 4\frac{1}{2}$ Long $4\frac{1}{2} \times 5\frac{1}{2}$ Buff or Rdway | | | \$ |
| 15 | Ft. | Copper C.I. C.I. | <u>3/4</u> in. | Pipe at <u>3/4</u> | \$ |
| | Nipples | in. at | | | \$ |
| | Bushings | to in. at | | | \$ |
| | Red'g Inc'g | Coupl'gs | to in. at | | \$ |
| | Union | in. at | | | \$ |
| | Meter | in. at | | | \$ |
| | Lead Joints | at | | | \$ |
| | Compound Joints | at | | | \$ |
| | Maintenance Foreman | | | | \$ |
| | Hrs. Water Maint. Man | 1 at | | | \$ |
| | Hrs. Water Maint. Man | 2 at | | | \$ |
| | Hrs. Garage Foreman | at | | | \$ |
| | Hrs. Labor | at | | | \$ |
| | Hrs. Compressor | at | | | \$ |
| | Compensation Ins. | at \$ | per C | | \$ |
| | Trucking | | | | \$ |
| | Pav't Patch | | | | \$ |
| | | | | | \$ |
| | | | | | \$ |
| | | | | | \$ |
| | O'head | | | | \$ |
| | | | | | \$ |

St.
Pl.
Ave. No. 189

BAY
Name of Owner

Labor and Mat'l. Report 19

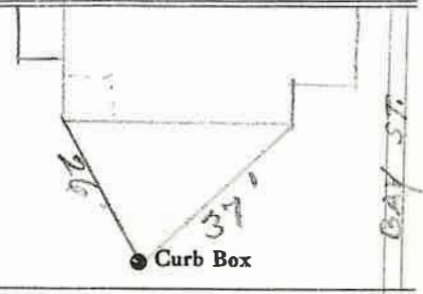

6 Main Elev. of Main at tap 5 1/2

Gate at ● ● Gate at

TAX ID # 302.12-16-6

TAP ON
BALDWIN
AVE. ● Curb Box