

LABOR AND MATERIALS


1	Copper Lead	} Connection $\frac{3}{4}$			\$
1	Curb	} Cock Valve T.S. & V.	} $\frac{3}{4}$ in.		\$
1	Service box Old returned	{ Short $3\frac{1}{2} \times 4\frac{1}{2}$ Long $4\frac{1}{2} \times 5\frac{1}{2}$ Buff or Rdway			\$
12	Ft. $\frac{3}{4}$ in.	{ Copper G.I. C.I.	} Pipe at		\$
	Nipples	in.	at		\$
	Bushings	to	in. at		\$
	Red'g				\$
	Inc'g	Coupl'gs	to in. at		\$
	Union	in.	at		\$
	Meter	in.	at		\$
	Lead Joints		at		\$
	Compound Joints		at		\$
	Maintenance Foreman				\$
	Hrs. Water Maint. Man	—1	at		\$
	Hrs. Water Maint. Man	—2	at		\$
	Hrs. Garage Foreman		at		\$
	Hrs. Labor		at		\$
	Hrs. Compressor		at		\$
	Compensation Ins.	at \$	per C		\$
	Trucking				\$
	Pav't Patch				\$
					\$
					\$
	O'head				\$
					\$

St.
~~Pl.~~
Ave. No. 193

BAY

Name of Owner _____

Labor and Mat'l. Report 19

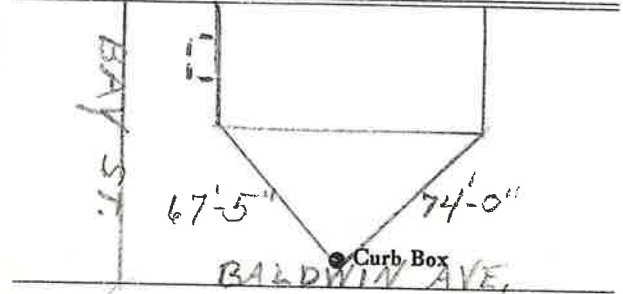

$6''$ Main Elev. of
Main at tap $5'$

Gate at • • Gate at

TAP ON BALDWIN AVE. • Curb Box