


LABOR AND MATERIALS

Copper	}	Connection			\$
Lead					
Curb	{	Cock Valve T. S. & V.			\$
Service Box	{	Short 3 1/2 x 4 1/2 Long 4 1/2 x 5 1/2 Buff. or Rdway			\$
Old returned					
Ft.	}	Copper Galv Iron Cast Iron			\$
3/4 in.					
Nipples					\$
Bushings					\$
Red'g	}	Couplings			\$
Inc'g					
Union					\$
Meter					\$
Lead Joints					\$
Leadite Joints					\$
Hrs. Foreman					\$
Hrs. Chauffeur					\$
Hrs. Tapper					\$
Hrs. Labor					\$
Hrs. Labor					\$
Hrs. Compressor					\$
Compensation Ins.					\$
Trucking					\$
Builders Use of Water					\$
					\$
					\$
					\$
					\$

St.
Pt.
Ave. No. 195

Name of Owner _____
TAX ID # 302.12-13-35

Labor and Mat'l. Report Aug. 17 1939

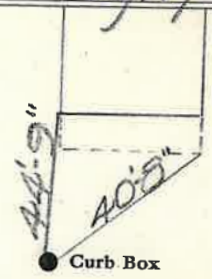

Main Elev. of
Main at tap

Gate at ● ● Gate at

● Curb Box