

LABOR AND MATERIALS

Copper	} Connection	_____	\$ _____	
Lead				
Curb	} Cock	} _____ in.	\$ _____	
				} Valve
Service box	} Short 3 1/2 x 4 1/2	} _____	\$ _____	
Old returned				} Long 4 1/2 x 5 1/2
14 Ft. 3/4 in.	} Copper	} Pipe at _____	\$ _____	
				} C.I.
Nipples	_____ in. at _____	\$ _____		
Bushings	_____ to _____ in. at _____	\$ _____		
Red'g	} Coupl'gs _____ to _____ in. at _____	\$ _____		
Inc'g				
Union	_____ in. at _____	\$ _____		
Meter	_____ in. at _____	\$ _____		
Lead Joints at _____	\$ _____			
Compound Joints at _____	\$ _____			
Maintenance Foreman _____	\$ _____			
Hrs. Water Maint. Man-1 at _____	\$ _____			
Hrs. Water Maint. Man-2 at _____	\$ _____			
Hrs. Garage Foreman _____ at _____	\$ _____			
Hrs. Labor _____ at _____	\$ _____			
Hrs. Compressor at _____	\$ _____			
Compensation Ins. at \$ _____ per C _____	\$ _____			
Trucking _____	\$ _____			
Pav't Patch _____	\$ _____			
_____	\$ _____			
_____	\$ _____			
_____	\$ _____			
O'head _____	\$ _____			
_____	\$ _____			


5/19/80 *Removal*

*BAY* St. \_\_\_\_\_  
 Pl. \_\_\_\_\_  
 Ave. No. *203*

Name of Owner \_\_\_\_\_  
 TAX ID # 302.12-10-18

Labor and Mat'l. Report

19

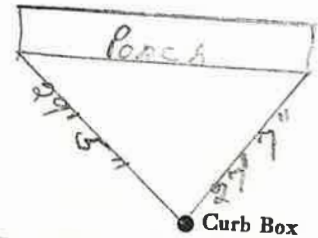

\_\_\_\_\_ Main \_\_\_\_\_ Elev. of Main at tap \_\_\_\_\_  
 Gate at ● \_\_\_\_\_ Gate at ● \_\_\_\_\_

● Curb Box

*2.4*