


LABOR AND MATERIALS

1	Copper	} Connection ^{3/4"}	\$	
	Lead			
1	Curb	} Cock Valve T.S. & V. } 1" in.	\$	
	Service box	} Short 3 1/2 x 4 1/2 }		
	Old returned		} Long 4 1/2 x 5 1/2 }	\$
14	Ft. 1"	} Copper } Pipe at	\$	
			} G. I. }	
			} G. I. }	
	Nipples	in. at	\$	
	Bushings	to in. at	\$	
	Red'g	} Coupl'gs to in. at	\$	
	Inc'g			
	Union	in. at	\$	
	Meter	in. at	\$	
			\$	
	Compound Joints	at	\$	
	Maintenance Foreman		\$	
	Hrs. Water Maint. Man—1	at	\$	
	Hrs. Water Maint. Man—2	at	\$	
	Hrs. Garage Foreman	at	\$	
	Hrs. Labor—	at	\$	
	Hrs. Compressor	at	\$	
			\$	
	Trucking		\$	
	Pav't Patch		\$	
			\$	
			\$	
			\$	
			\$	

St. PL
 Ave. No. 207
 Name of Owner BAY
 TAX ID # 302.12-10-17

Labor and Mat'l. Report DFC 1923

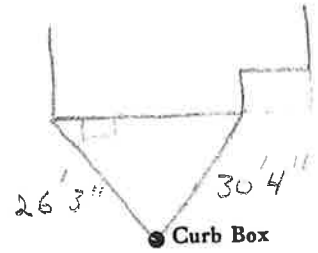

6" Main Elev. of Main at tap 6'
 Gate at ● ● Gate at
 ● Curb Box

