


LABOR AND MATERIALS

1	Copper	}	Connection	<u>3/4</u>		\$	
	Lead						
1	Curb	}	Cock Valve	<u>3/4</u>	in.	\$	
			T. S. & V.				
1	Service box	}	Short $3\frac{1}{2} \times 4\frac{1}{2}$				
	Old returned		Long $4\frac{1}{2} \times 5\frac{1}{2}$				
			Buff or Rdway			\$	
<u>36</u>	Ft.	}	Copper		} Pipe at	\$	
	<u>3/4</u>		G. I.				
	in.		C. I.				
	Nipples		in.			\$	
	Bushings		to		in. at	\$	
	Red'g	}	Inc'g		} Coupl'gs to	} in. at	\$
	Union						in.
	Meter		in.			\$	
	Lead Joints		at			\$	
	Compound Joints		at			\$	
	Maintenance Foreman					\$	
	Hrs. Water Maint. Man		—1 at			\$	
	Hrs. Water Maint. Man		—2 at			\$	
	Hrs. Garage Foreman		at			\$	
	Hrs. Labor		at			\$	
	Hrs. Compressor		at			\$	
	Compensation Ins.		at \$		per C	\$	
	Trucking					\$	
	Pav't Patch					\$	
						\$	
						\$	
						\$	
	O'head					\$	
						\$	

St.
 Pl.
 Ave. No. 66

Name of Owner _____

Labor and Mat'l. Report 19

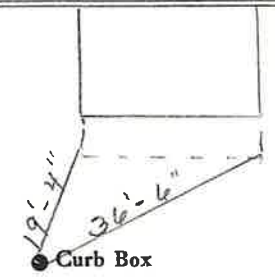

Elev. of Main at tap 5

Gate at ● ● Gate at

● Curb Box