

LABOR AND MATERIALS


Copper	} Connection	_____	\$ _____	
Lead				
Curb	} Cock	_____ in.	\$ _____	
				} Valve
Service box	} Short 3½ x 4½	_____	\$ _____	
				Old returned
12 Ft.	1 in.	} Copper	} Pipe at _____	
				} G.I.
		} G.I.		
Nipples	_____ in.		at _____	\$ _____
Bushings	_____ to _____	in. at _____	\$ _____	
Red'g	} Coupl'gs	_____ to _____	in. at _____	
Inc'g				
Union	_____ in.	at _____	\$ _____	
Meter	_____ in.	at _____	\$ _____	
			\$ _____	
Compound Joints	_____		\$ _____	
Maintenance Foreman	_____		\$ _____	
Hrs. Water Maint. Man—1	_____ at _____		\$ _____	
Hrs. Water Maint. Man—2	_____ at _____		\$ _____	
Hrs. Garage Foreman	_____ at _____		\$ _____	
Hrs. Labor—	_____ at _____		\$ _____	
Hrs. Compressor	_____ at _____		\$ _____	
			\$ _____	
Trucking	_____		\$ _____	
Pav't Patch	_____		\$ _____	
			\$ _____	
			\$ _____	
BAY

St. ~~Pl.~~ Ave. No. 211

Name of Owner \_\_\_\_\_  
 TAX ID # 302.12-7-16

Labor and Mat'l. Report \_\_\_\_\_ 19 97

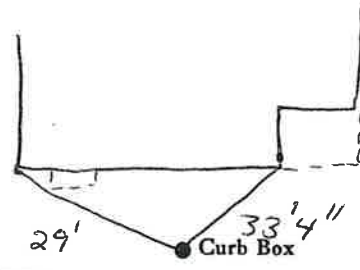

\_\_\_\_\_ Main Elev. of Main at tap \_\_\_\_\_  
 Gate at • • Gate at

• Curb Box

RENEWAL TAP