


LABOR AND MATERIALS

1	Copper Lead	} Connection ^{3/4"}	\$
1	Curb		} Cock Valve T.S. & V. } 1" in.
1	Service box Old returned	} Short 3 1/2 x 4 1/2 } Long 4 1/2 x 5 1/2 }	
13	Ft. 1" in.		} Copper G. I. C. I. } Pipe at.
	Nipples	in. at	
	Bushings	to in. at	\$
	Red'g Inc'g	} Coupl'gs to in. at	\$
	Union		in. at
	Meter	in. at	\$
	Compound Joints	at	\$
	Maintenance Foreman		\$
	Hrs. Water Maint. Man—1	at	\$
	Hrs. Water Maint. Man—2	at	\$
	Hrs. Garage Foreman	at	\$
	Hrs. Labor—	at	\$
	Hrs. Compressor	at	\$
	Trucking		\$
	Pav't Patch		\$
			\$
			\$
BAY St. Ave. No. *215*
 Name of Owner
 TAX ID # 302.12-7-15

Labor and Mat'l. Report *APR. 19 27*

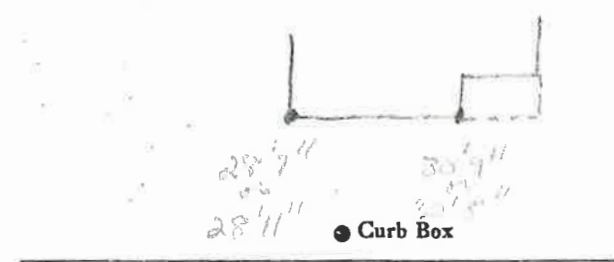

6" Main Elev. of Main at tap *6'*
 Gate at • Gate at •

• Curb Box