

LABOR AND MATERIALS


Copper	} Connection		\$			
Lead						
Curb	} Cock Valve T. S. & V.	} in.	\$			
				Service box	{ Short 3½ x 4½ Long 4½ x 5½ Buff or Rdway	\$
14 Ft. 4 in.	} Copper G. I. C. P.	} Pipe at	\$			
Nipples				in. at	\$	
Bushings				to in. at	\$	
Red'g Inc'g	} Coupl'gs	to in. at	\$			
Union				in. at	\$	
Meter	in. at	\$				
Lead Joints	at	\$				
Compound Joints	at	\$				
Maintenance Foreman		\$				
Hrs. Water Maint. Man—1	at	\$				
Hrs. Water Maint. Man—2	at	\$				
Hrs. Garage Foreman	at	\$				
Hrs. Labor—	at	\$				
Hrs. Compressor	at	\$				
Compensation Ins. at \$	per C	\$				
Trucking		\$				
Pav't Patch		\$				
		\$				
		\$				
		\$				
O'head		\$				
		\$				

St.
-Pl.
Ave. No. 219

BAY
Name of Owner

Labor and Mat'l. Report

19

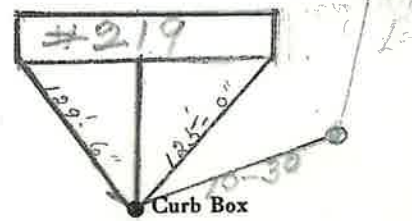

6" Main Elev. of Main at tap 4'

Gate at ● ● Gate at

● Curb Box