


LABOR AND MATERIALS

1	Copper Lead	} Connection	<u>3/4</u>		\$
1	Curb	} Cock Valve T-S. & V.	<u>3/4 in.</u>		\$
1	Service box Old returned	{ Short 3 1/2 x 4 1/2 Long 4 1/2 x 5 1/2 Buff or Rdway			\$
16	Ft. <u>3/4</u> in.	{ Copper G.I. G.I.	} Pipe at		\$
	Nipples	in. at			\$
	Bushings	to in. at			\$
	Red'g Inc'g	} Coupl'gs	to in. at		\$
	Union	in. at			\$
	Meter	in. at			\$
	Lead Joints	at			\$
	Compound Joints	at			\$
	Maintenance Foreman				\$
	Hrs. Water Maint. Man-1	at			\$
	Hrs. Water Maint. Man-2	at			\$
	Hrs. Garage Foreman	at			\$
	Hrs. Labor	at			\$
	Hrs. Compressor	at			\$
	Compensation Ins. at \$		per C		\$
	Trucking				\$
	Pav't Patch				\$
					\$
					\$
	O'head				\$
					\$

St.
-Pt.
Ave. No. 225-

BAY
Name of Owner
TAX ID # 302.12-3-14

Labor and Mat'l. Report 19

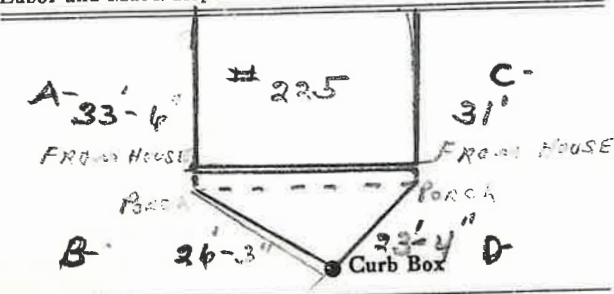

6" Main Elev. of Main at tap 4 1/2

Gate at ● ● Gate at

● Curb Box